ARCHIVE DOCUMENT

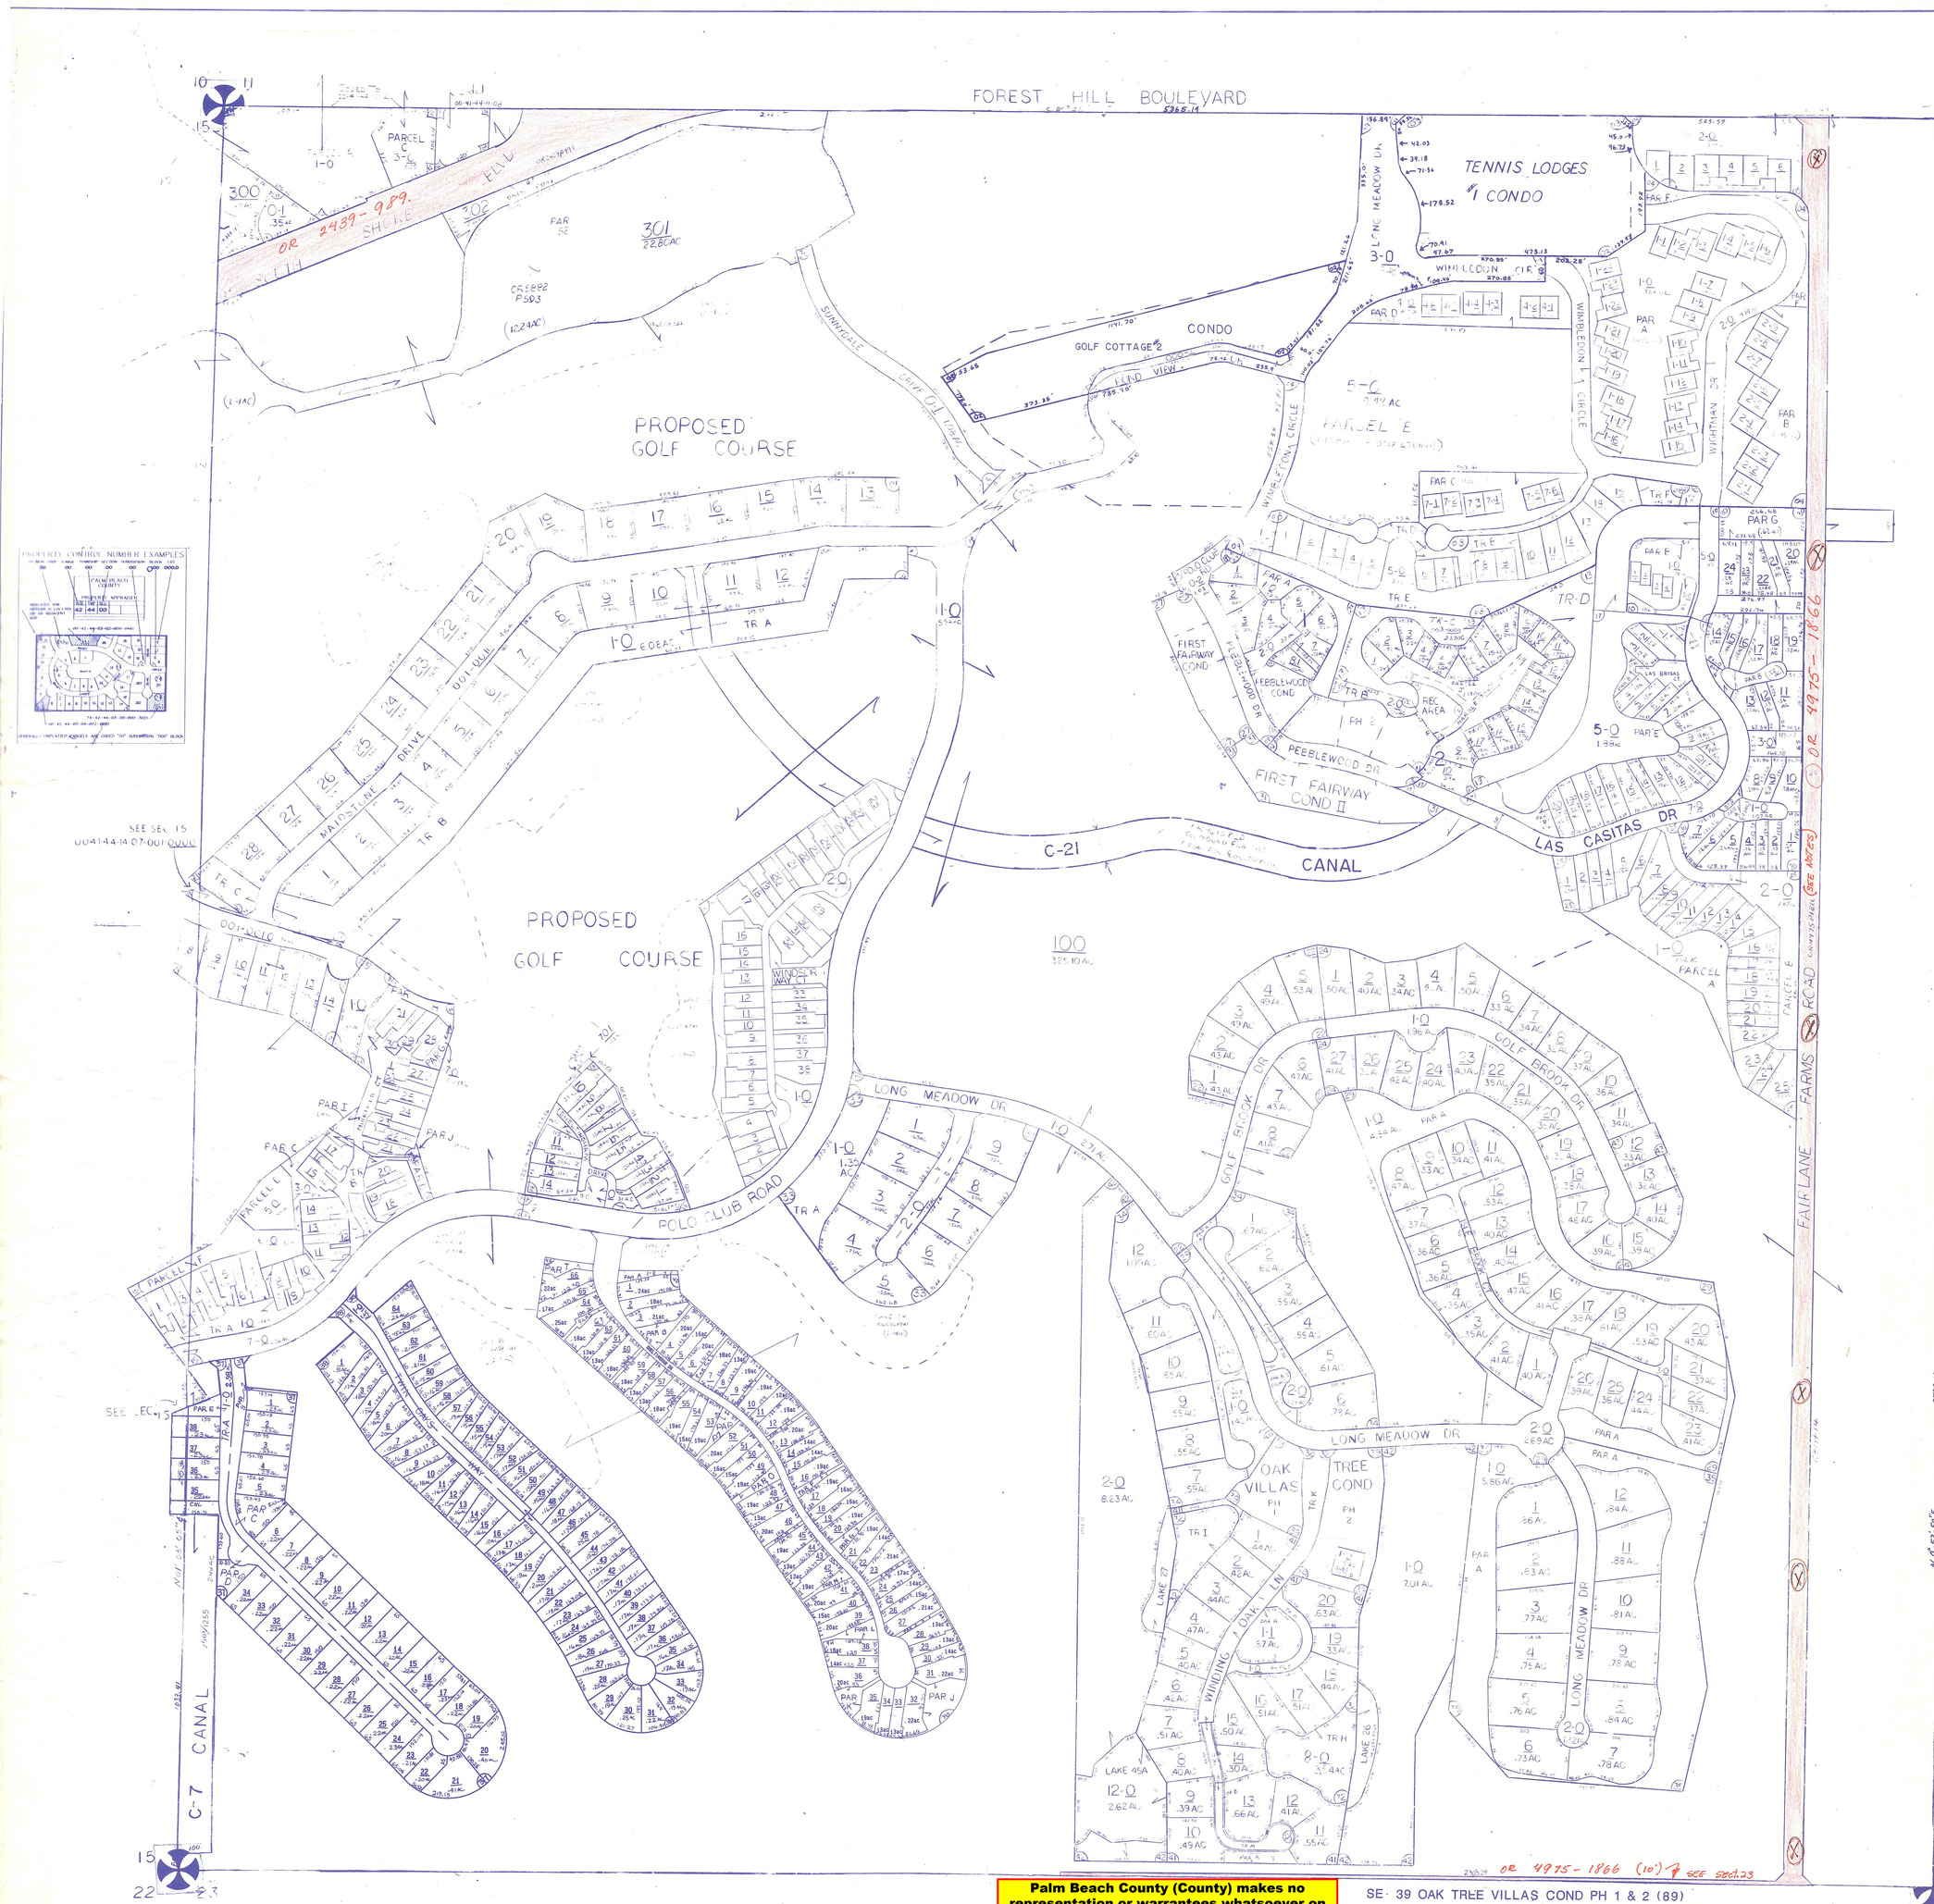

NOTES

- FAIRLANE FARMS RD:
  - × GOULD FLORIDA TO P.B.C. OR 3631-852
  - × P.B.C. TO GOULD FLORIDA: OR 4975-1863
  - × GOULD FLORIDA ~~RECONVEYD~~ TO P.B.C. by OR. 4975-1866 FOR NEW ALIGNMENT.
- (*) ROADS REMOVED FROM RD. MAINTENANCE INVENTORY AS RESULT OF WELLINGTON INCORPORATION ON NOV. 7, 1995.

NE 01 GOLF & TENNIS VILLAGE PH 1 OF P.B. POLO & CTRY CLUB (1979) PB35P185
NE 02 GOLF COTTAGE #2 COND
NE 03 TENNIS LODGES #1 COND (1980) PH 1 & 2
NE 04 GOLF & TENNIS VILLAGE PH 2A OF P.B. POLO & CTRY CLUB (1982) PB41P130
NE 05 GOLF & TENNIS VILLAGE PH 3 OF P.B. POLO & CTRY CLUB (1982) PB42P132
NW 06 MAIDSTONE NO.1 P.B. POLO & CTRY CLUB WELLINGTON (1983) PB44P20
SW 07 LONGWOOD GREEN P.B. POLO & CTRY CLUB WELLINGTON (1983) PB44P55 LTS 1 TO 6 & PT OF POLO CLUB RD ABND-RES R-82-938
NE 08 GOLF & TENNIS VILLAGE PAR C P.B. POLO & CTRY CLUB WELLINGTON (1983) PB44P184 (00)
NE 09 PEBBLEWOOD PH 1 OF P.B. POLO & CTRY CLUB WELLINGTON (1983) PB45P35
NE 10 LAS CASITAS PH 1 OF P.B. POLO & COUNTRY CLUB (1984) PB45P51 (00)
NE 11 PEBBLEWOOD COND (1984) PH 2 (1985)
NE 12 PEBBLEWOOD PH 2 OF P.B. POLO & CTRY CLUB WELLINGTON (1984) PB46P76
NE 13 PEBBLEWOOD PH 3 OF P.B. POLO & CTRY CLUB (1985) PB47P128
W 14 POLO CLUB RD PL 1 OF P.B. POLO & CTRY CLUB WELLINGTON (1985) PB48P28
SW 15 MUIRFIELD PL 1 OF P.B. POLO & CTRY CLUB WELLINGTON (1985) PB48P30
NW 16 PL 3 TOWNCENTER OF WELLINGTON (1985) PB48P121
NE 17 LAS CASITAS PH 2 PB49P54
NE 18 REPL OF LT 15 LONGWOOD GREEN (1985) PB49P84
SW 19 MUIRFIELD PL 2 OF P.B. POLO & CTRY CLUB WELLINGTON (1985) PB49P166
NE 20 ~~FIRST FAIRWAY COND PL 1 P.B. POLO & CTRY CLUB WELLINGTON PB49P191~~ PARCEL 01 & 21
NE 21 ~~FIRST FAIRWAY COND PL 2 (1986) PB50P157~~
SE 22 BROOKSIDE PL 1 (1986) PB50P175 TRACT A1 SUB 31
NE 23 PEBBLEWOOD PH 4 (1986) PB51P4
SE 24 BROOKSIDE PL 2 (1986) PB51P95
NE 25 LAS CASITAS PL 3 (1986) PB52P23
N½ 26 WINDSOR WAY PL 1 (1986) PB52P99
NE 27 FIRST FAIRWAY COND (86)
SW 28 WINDSOR WAY PL 2 (1987) PB52P176
SE 29 BROOKSIDE PL 3 (1987) PB54P75
NE 30 LAS CASITAS PL 4 (1987) PB54P110
NE 31 FIRST FAIRWAY COND II (1987) (88)
SE 32 OAK TREE VILLAS (88) PB57P112
SW 33 FAIRWAY ISLAND OF P.B. POLO & CTRY CLUB WELLINGTON (88) PB57P116
SE 34 OAK TREE ESTATES (88) PB57P121
SE 35 BROOKSIDE PL 4 OF P.B. POLO & CTRY CLUB WELLINGTON (88) PB58P45
NW 36 SUNNYDALE DR OF P.B. POLO & CTRY CLUB WELLINGTON (88) PB58P82

ALL OF SECTION IN COUNTY 00

SW 37 BENT CYPRESS (89) PB59 P13
SW 38 SHADY OAKS OF PALM BEACH & COUNTRY CLUB (89) PB 59P117

SUES CONTINUED BELOW

SE 39 OAK TREE VILLAS COND PH 1 & 2 (89)
SW 40 KENSINGTON OF PALM BEACH POLO & CTRY CLUB WELLINGTON (90) PB62P69
SE 41 WINDING OAKS (92) PB68P145
SE 42 DUNES PL 1 HOLES 14 & 15 (92) PB68P158
SE 43 LUBELLS SUB (93) PB69P164

NOTE: NOT TO BE REPRODUCED IN ANY FORM EXCEPT BY EXPRESS WRITTEN CONSENT FROM THE PALM BEACH COUNTY ASSESSOR.

Information shown hereon is compiled from the best available sources and CANNOT be used for surveys or land transfers of any type.

Palm Beach County (County) makes no representation or warrantees whatsoever on the attached / enclosed information reflected herein pertaining to easements, rights-of-way, setback lines, reservations, agreements, and other similar matters. The information provided herein should not be relied upon by the requesting party to confirm the existence / non-existence of facts contained herein.

M-23

PALM BEACH COUNTY
GARY R. NIKOLITS
PROPERTY APPRAISER

RGE	TWP	SEC	AERIAL
41	44	14	NO/50 B

SCALE 1:200'
DRAWN BY 01/15
UPDATED